

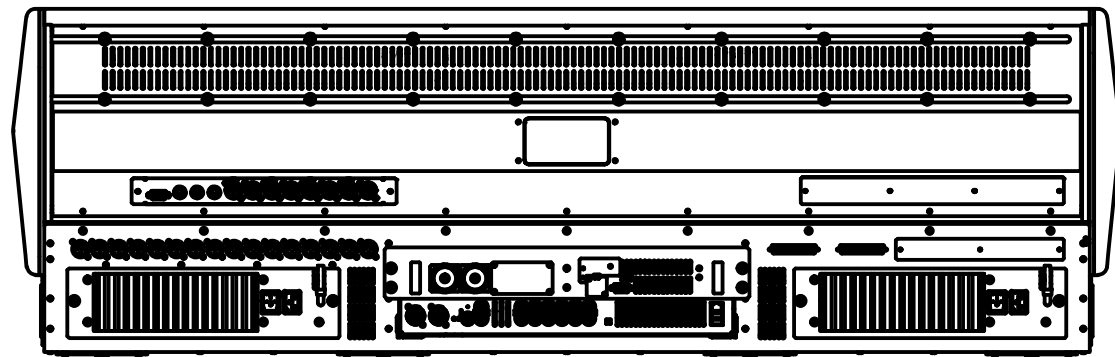
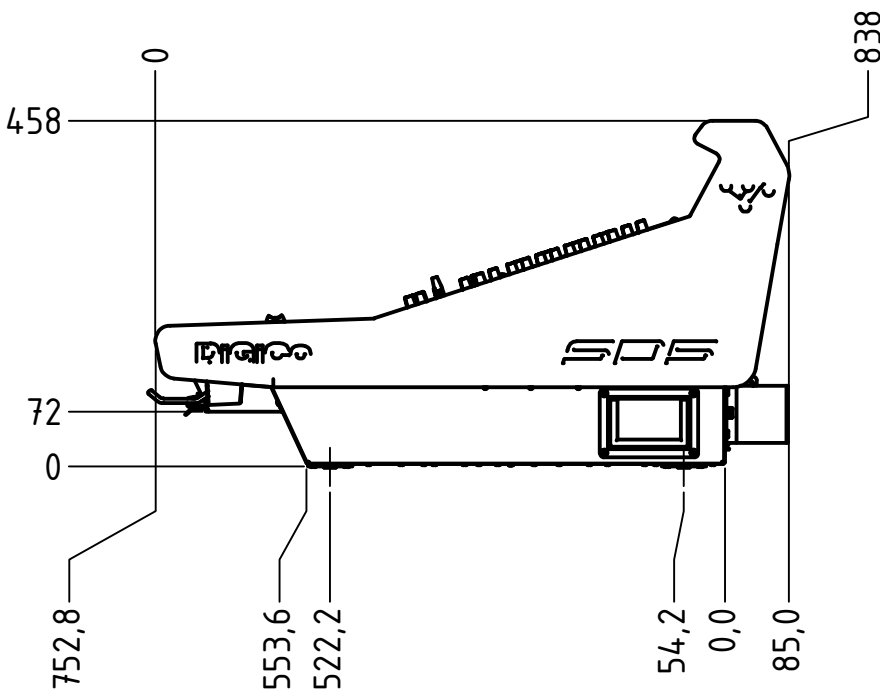
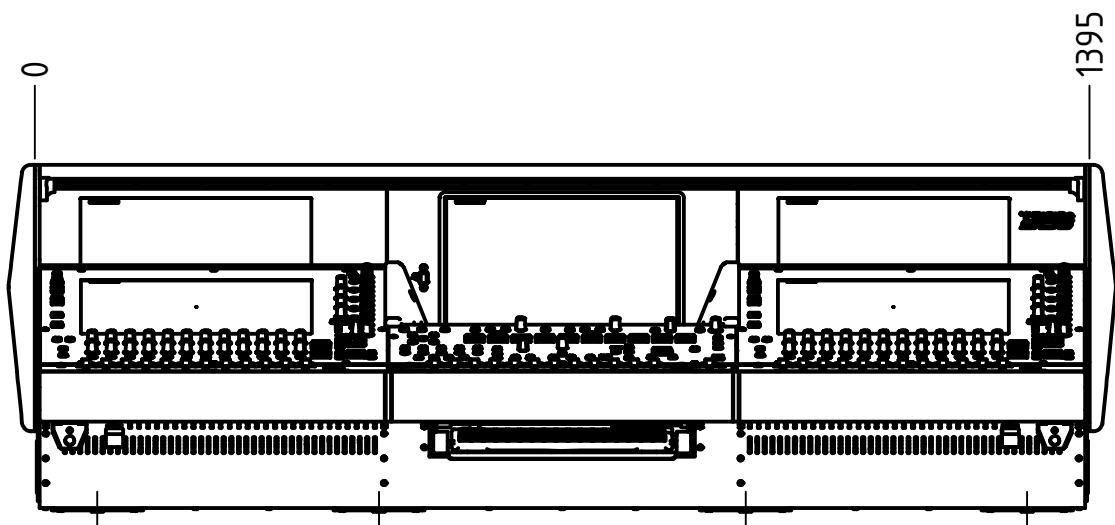
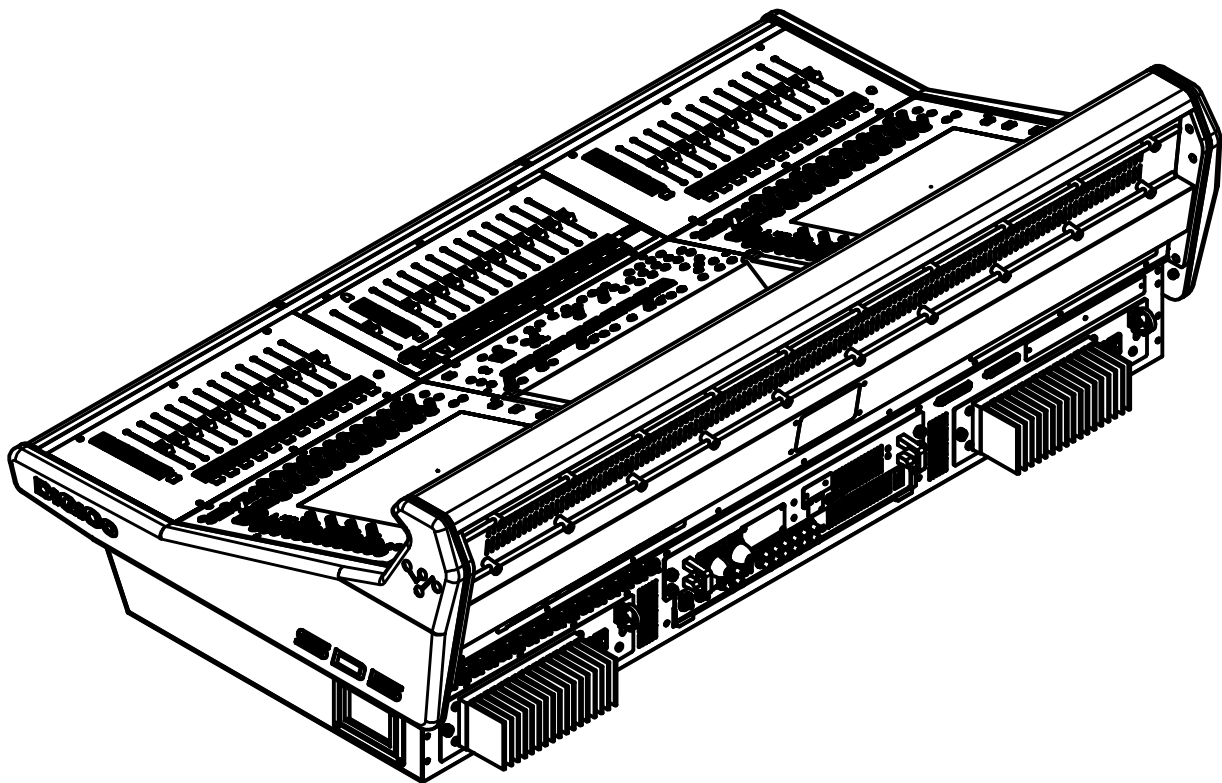
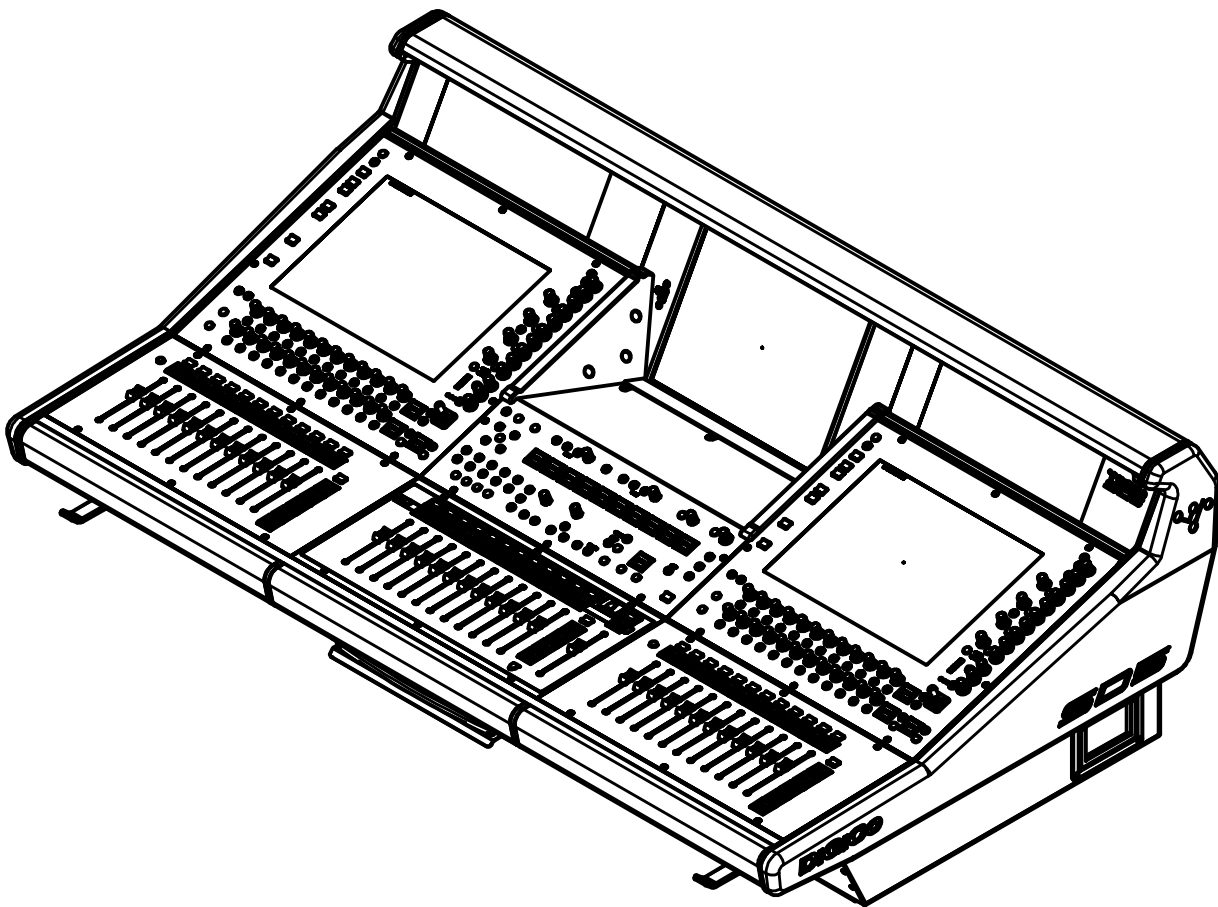
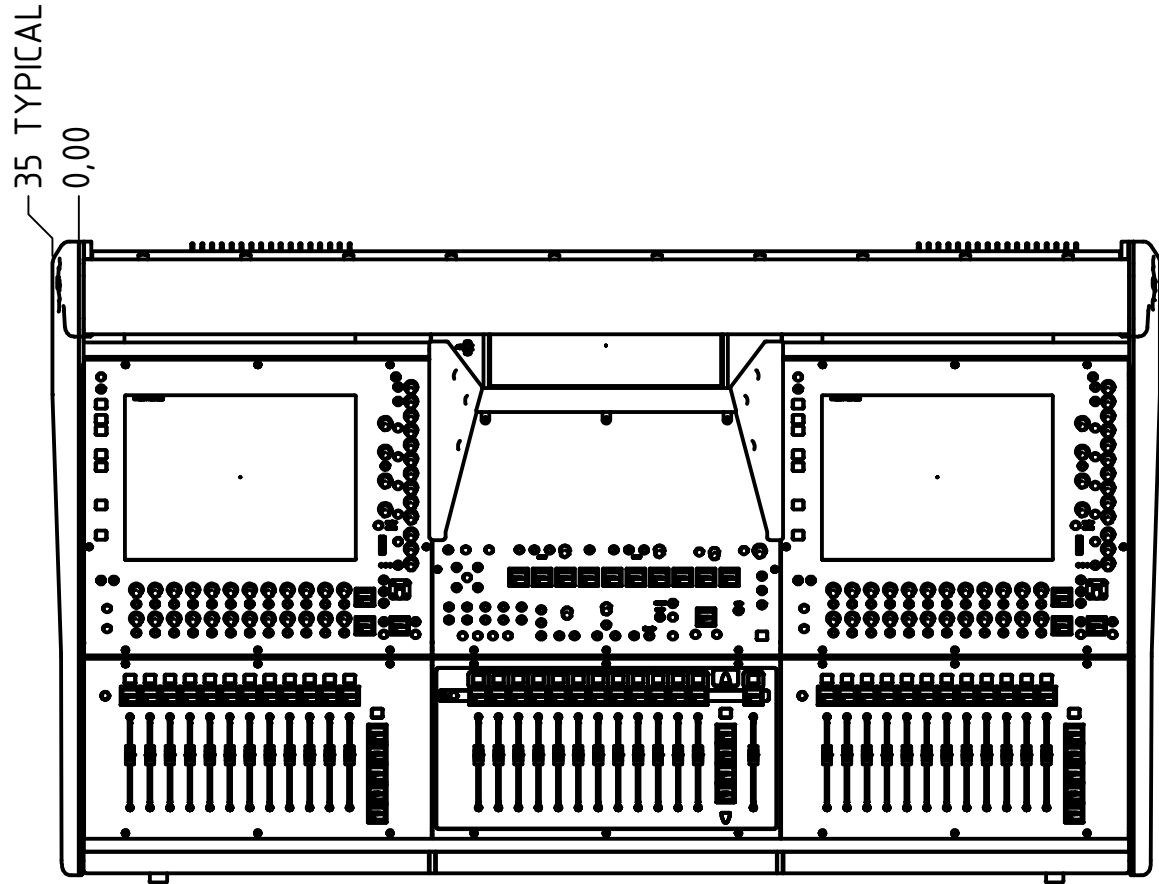
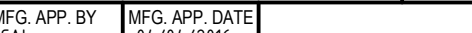


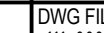


REVISION HISTORY				
ZONE	REV	DESCRIPTION	DATE	CHANGE NO.
	1	AS BUILT	04/04/2016	

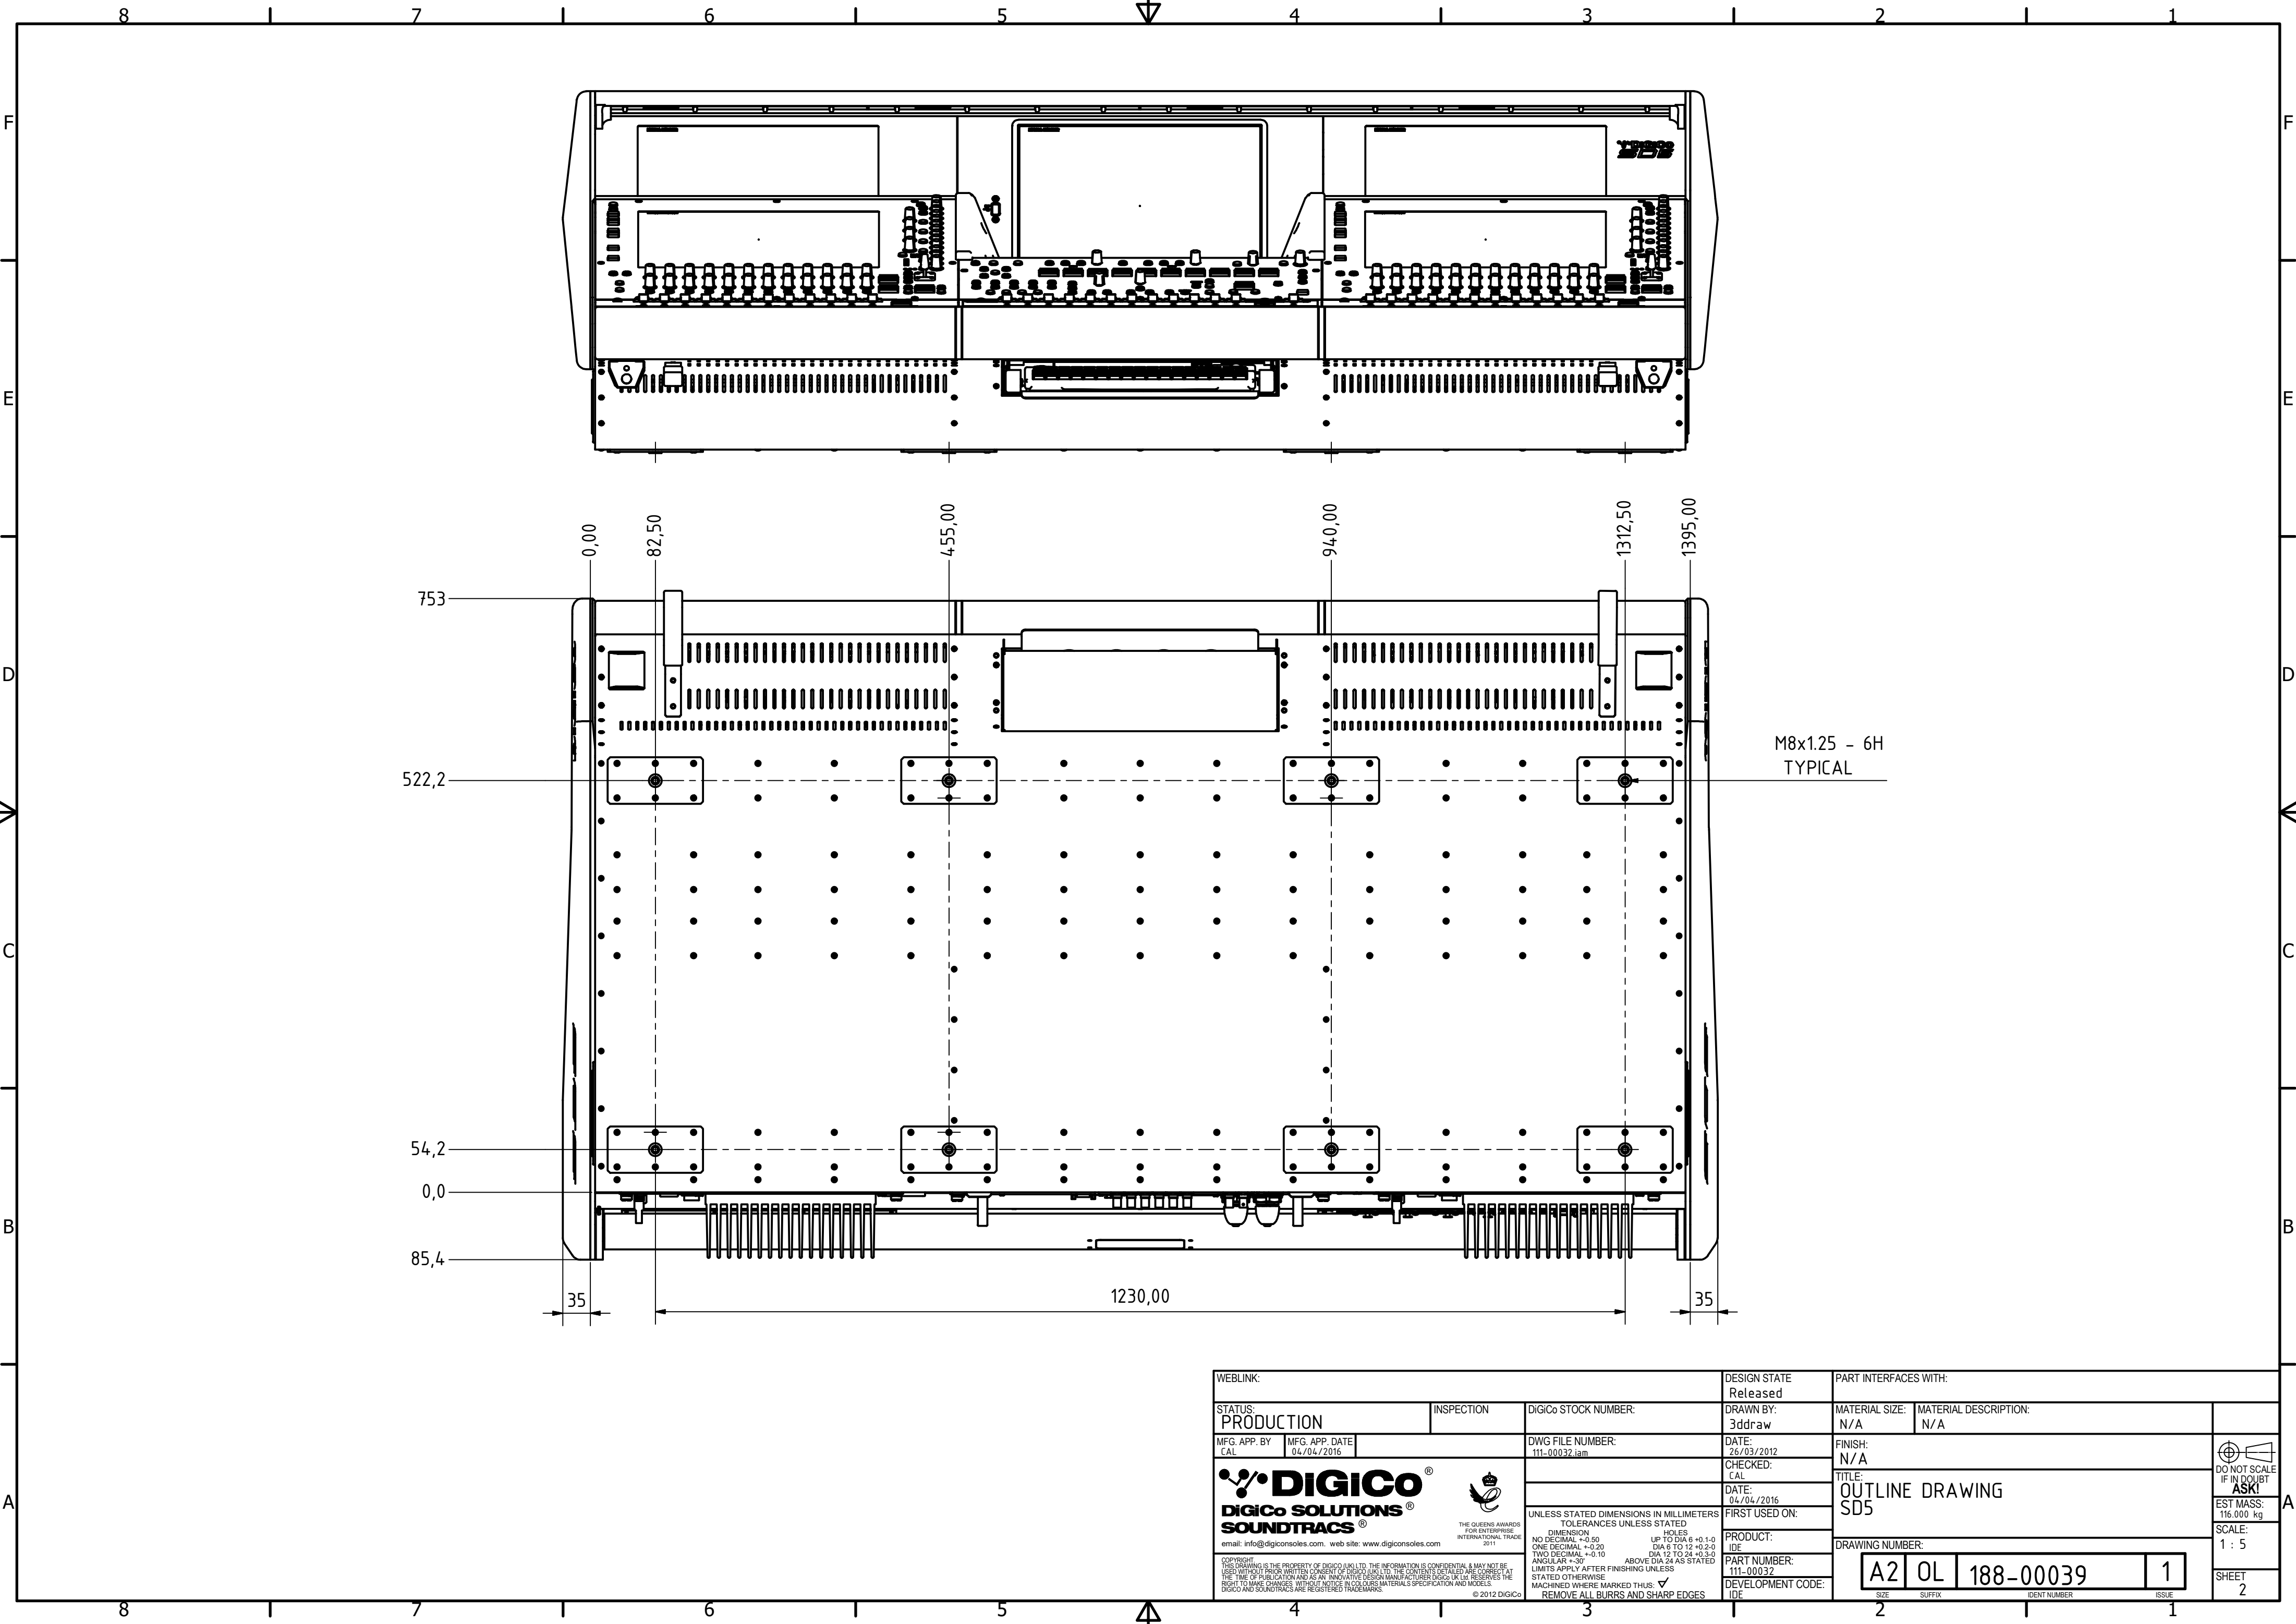

ESTIMATED WEIGHT: 116 kg.

WEBLINK:			DESIGN STATE Released		PART INTERFACES WITH:					
STATUS: PRODUCTION		INSPECTION	DIGiCo STOCK NUMBER:		DRAWN BY: 3ddraw	MATERIAL SIZE: N/A	MATERIAL DESCRIPTION: N/A			
MFG. APP. BY CAL	MFG. APP. DATE 04/04/2016		DWG FILE NUMBER: 111-00032.iam	DATE: 26/03/2012		FINISH: N/A				
 <b>DIGiCo SOLUTIONS®</b> <b>SOUNDTRACS®</b> <small>email: info@digiconsols.com    web site: www.digiconsols.com</small>					CHECKED: CAL					
					DATE: 04/04/2016					
					FIRST USED ON:					
<small>COPYRIGHT: THIS DRAWING IS THE PROPERTY OF DIGICO (UK) LTD. THE INFORMATION IS CONFIDENTIAL &amp; MAY NOT BE USED WITHOUT PRIOR WRITTEN CONSENT OF DIGICO (UK) LTD. THE CONTENTS DETAILLED ARE CORRECT AT THE TIME OF PUBLICATION AND AS AN INNOVATIVE DESIGN MANUFACTURER DIGICO (UK) LTD. RESERVES THE RIGHT TO MAKE CHANGES WITHOUT NOTICE IN COLOURS MATERIALS SPECIFICATION AND MODELS. DIGICO AND SOUNDTRACS ARE REGISTERED TRADEMARKS.</small>			<small>THE QUEEN'S AWARD FOR ENTERPRISE INTERNATIONAL TRADE 2011</small>	<small>UNLESS STATED DIMENSIONS IN MILLIMETERS TOLERANCES UNLESS STATED DIMENSION NO DECIMAL <math>\pm 0.50</math> ONE DECIMAL <math>\pm 0.20</math> TWO DECIMAL <math>\pm 0.10</math> ANGULAR <math>\sim 30'</math> UP TO DIA 6 <math>\pm 0.1-0</math> DIA 6 TO 12 <math>\pm 0.2-0</math> DIA 12 TO 24 <math>\pm 0.3-0</math> ABOVE DIA 24 AS STATED LIMITS APPLY AFTER FINISHING UNLESS STATED OTHERWISE MACHINED WHERE MARKED THUS: <math>\nabla</math> REMOVE ALL BURRS AND SHARP EDGES</small>		PRODUCT: IDE				
						PART NUMBER: 111-00032				
						DEVELOPMENT CODE: IDE				
						DRAWING NUMBER:				
						A2	188-00039	1	SHEET 1	
						SIZE	SUFFIX	IDENT NUMBER	ISSUE	



WEBLINK:			DESIGN STATE Released		PART INTERFACES WITH:													
STATUS: PRODUCTION		INSPECTION	DIGICo STOCK NUMBER:		DRAWN BY: 3ddraw	MATERIAL SIZE: N/A	MATERIAL DESCRIPTION: N/A											
MFG. APP. BY CAL	MFG. APP. DATE 04/04/2016		DWG FILE NUMBER: 111-00032.iam		DATE: 26/03/2012	FINISH: N/A		 DO NOT SCALE IF IN DOUBT <b>ASK!</b>										
 <b>DIGICo SOLUTIONS® SOUNDTRACS®</b> email: info@digiconsoles.com    web site: www.digiconsoles.com		 THE QUEENS AWARDS FOR ENTERPRISE INTERNATIONAL TRADE 2011	UNLESS STATED DIMENSIONS IN MILLIMETERS TOLERANCES UNLESS STATED DIMENSION NO DECIMAL +0.50 UP TO DIA 8 +0.1-0 ONE DECIMAL +0.20 DIA 8 TO 12 +0.2-0 TWO DECIMAL +0.10 DIA 12 TO 24 +0.3-0 ANGULAR ±.30 ABOVE DIA 24 AS STATED LIMITS APPLY AFTER FINISHING UNLESS STATED OTHERWISE MACHINED WHERE MARKED THUS: ✓ REMOVE ALL BURRS AND SHARP EDGES		CHECKED: CAL	TITLE: OUTLINE DRAWING SD5												
					DATE: 04/04/2016													
					FIRST USED ON:													
<small>COPYRIGHT THIS DRAWING IS THE PROPERTY OF DIGICO UK LTD. THE INFORMATION IS CONFIDENTIAL &amp; MAY NOT BE USED WITHOUT PRIOR WRITTEN CONSENT OF DIGICO UK LTD. THE CONTENTS DETAIL ARE CORRECT AT THE TIME OF PUBLICATION AND AS AN INNOVATIVE DESIGN MANUFACTURER DIGICO UK LTD. RESERVES THE RIGHT TO MAKE CHANGES WITHOUT NOTICE IN COLOURS MATERIALS SPECIFICATION AND MODELS. DIGICO AND SOUNDTRACS ARE REGISTERED TRADEMARKS. © 2012 DIGICO</small>					PRODUCT: IDE	DRAWING NUMBER:												
					PART NUMBER: 111-00032	SCALE: 1 : 5												
					DEVELOPMENT CODE: IDE	<table><tr><td>A2</td><td>OL</td><td>188-00039</td><td>1</td></tr><tr><td>SIZE</td><td>SUFFIX</td><td>IDENT NUMBER</td><td>ISSUE</td></tr></table>		A2	OL	188-00039	1	SIZE	SUFFIX	IDENT NUMBER	ISSUE			
A2	OL				188-00039	1												
SIZE	SUFFIX	IDENT NUMBER	ISSUE															
						SHEET 2												